




DESIGN <i>[Signature]</i>	DRAWN BY <i>[Signature]</i>	DART AEROSPACE LTD HAWKESBURY, ONTARIO, CANADA	
CHECKED RF	APPROVED <i>[Signature]</i>	DRAWING NO. D2421	REV. F SHEET 1 OF 2
DATE 01.03.12		TITLE BEARPAW	SCALE 1:7
A	95.04.24	NEW ISSUE	
B	95.11.28	CHANGED NUMBER OF HOLES	
C	97.06.19	ADDED MATERIAL SPECIFICATION	
D	98.08.11	DIM MODIFICATIONS	
E	00.03.01	R1.77 WAS R2.66; ADD R1.85 BORE RELIEF FOR CLAMPS; ADDED DEO 9155	
F	01.03.12	MODIFY FWD END	
F1	<del>03.01.13</del>	<del>Ø0.93 WAS Ø0.75; R0.19 WAS R0.38;</del> Ø0.19 WAS 0.25	
F2	<del>04.11.03</del>	0.30 WAS 0.40 ; 0.650 WAS 0.55	

RELEASED  
01.03.14

ENGRAVE DART LOGO TO  
MAX DEPTH OF 0.012.  
ENGRAVE PART AND BATCH  
NUMBERS TO MAX DEPTH  
OF 0.010. (TYPICAL  
LOCATION AS ILLUSTRATED)

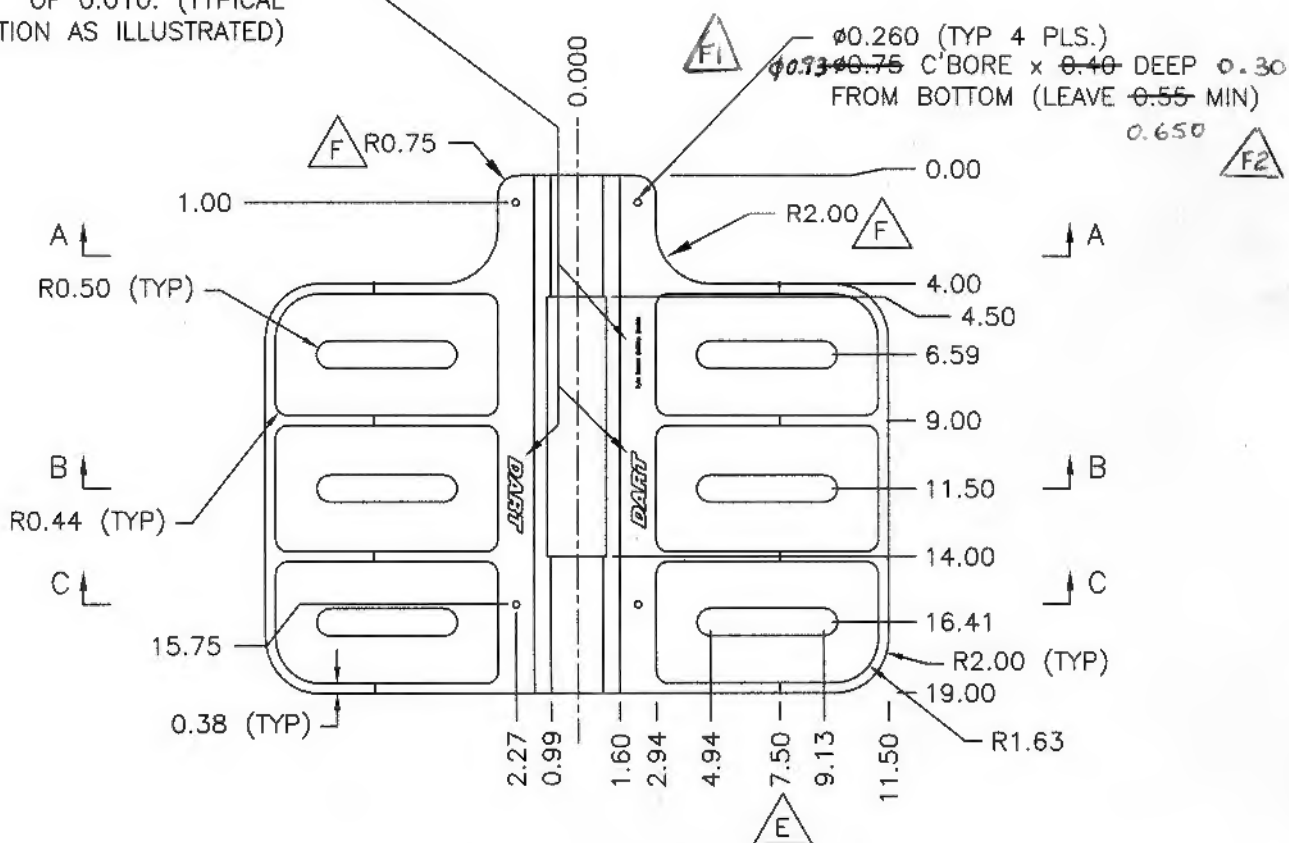

SYMMETRIC ABOUT CENTER LINE

MATERIAL: UHMW BLACK PER SPEC CONTROL DRAWING D2689,  
1.00" THICK (MACHINE TO 0.950)


Copyright © 1995 by DART AEROSPACE LTD

THIS DOCUMENT IS PRIVATE AND CONFIDENTIAL AND IS SUPPLIED ON THE EXPRESS CONDITION THAT IT IS NOT TO BE USED FOR ANY PURPOSE OR COPIED OR COMMUNICATED TO ANY OTHER PERSON WITHOUT WRITTEN PERMISSION FROM DART AEROSPACE LTD.




DESIGN <i>[Signature]</i>	DRAWN BY <i>[Signature]</i>	DART AEROSPACE LTD HAWKESBURY, ONTARIO, CANADA	
CHECKED RF	APPROVED <i>[Signature]</i>	DRAWING NO. D2421	REV. F SHEET 2 OF 2
DATE 01.03.12	TITLE BEARPAW SCALE 1:6		


RELEASED  
01.03.14 *[Signature]*

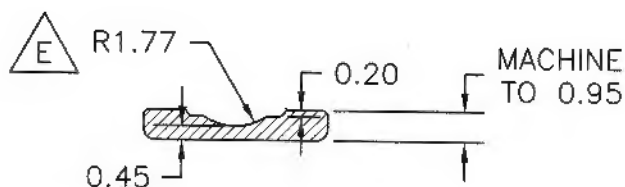

SECTION A-A

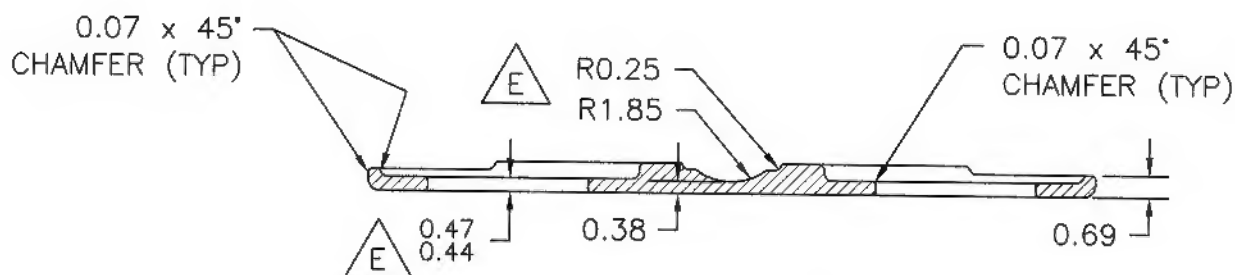

SECTION B-B

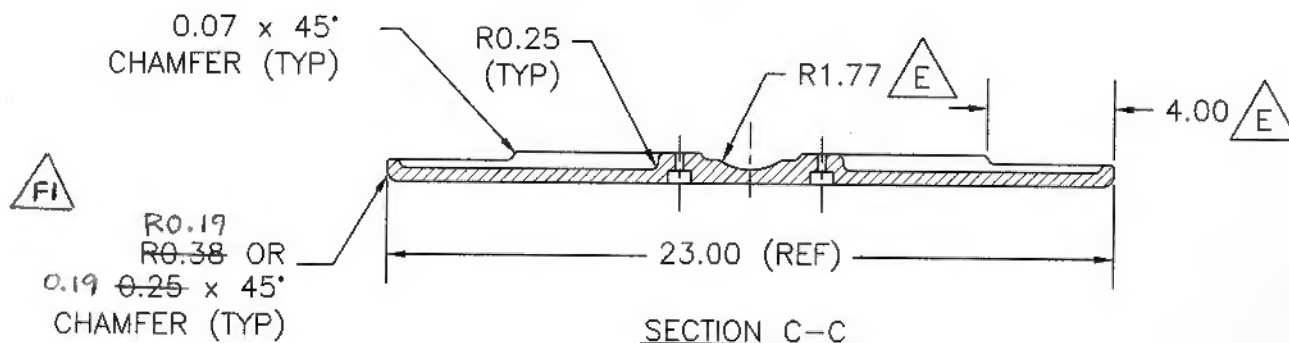

SECTION C-C

Copyright © 1995 by DART AEROSPACE LTD

THIS DOCUMENT IS PRIVATE AND CONFIDENTIAL AND IS SUPPLIED ON THE EXPRESS CONDITION THAT IT IS NOT TO BE USED FOR ANY PURPOSE OR COPIED OR COMMUNICATED TO ANY OTHER PERSON WITHOUT WRITTEN PERMISSION FROM DART AEROSPACE LTD.